


GROUND FLOOR RECORD PLAN

This line should measure 100mm along x and y axes when printed

# RECORD PLAN

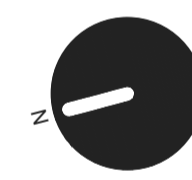

Revisions				
Revision	Date	Revision notes	Drawn	Checked

Client  
Butters John Bee

Job title  
Record Plans  
The Barracks Workshops  
Newcastle-Under-Lyme  
ST5 1LG

Drawing title  
Ground Floor  
Record Plan

Check all dimensions and verify on site. Report any errors or omissions. © Arni Architects Ltd

First issued	18-12-17
Drawn by	MD
Drawing sheet size	A1
Scale	1:100
Inspected by	TA
Drawing number	6161 001
Revision	-

